


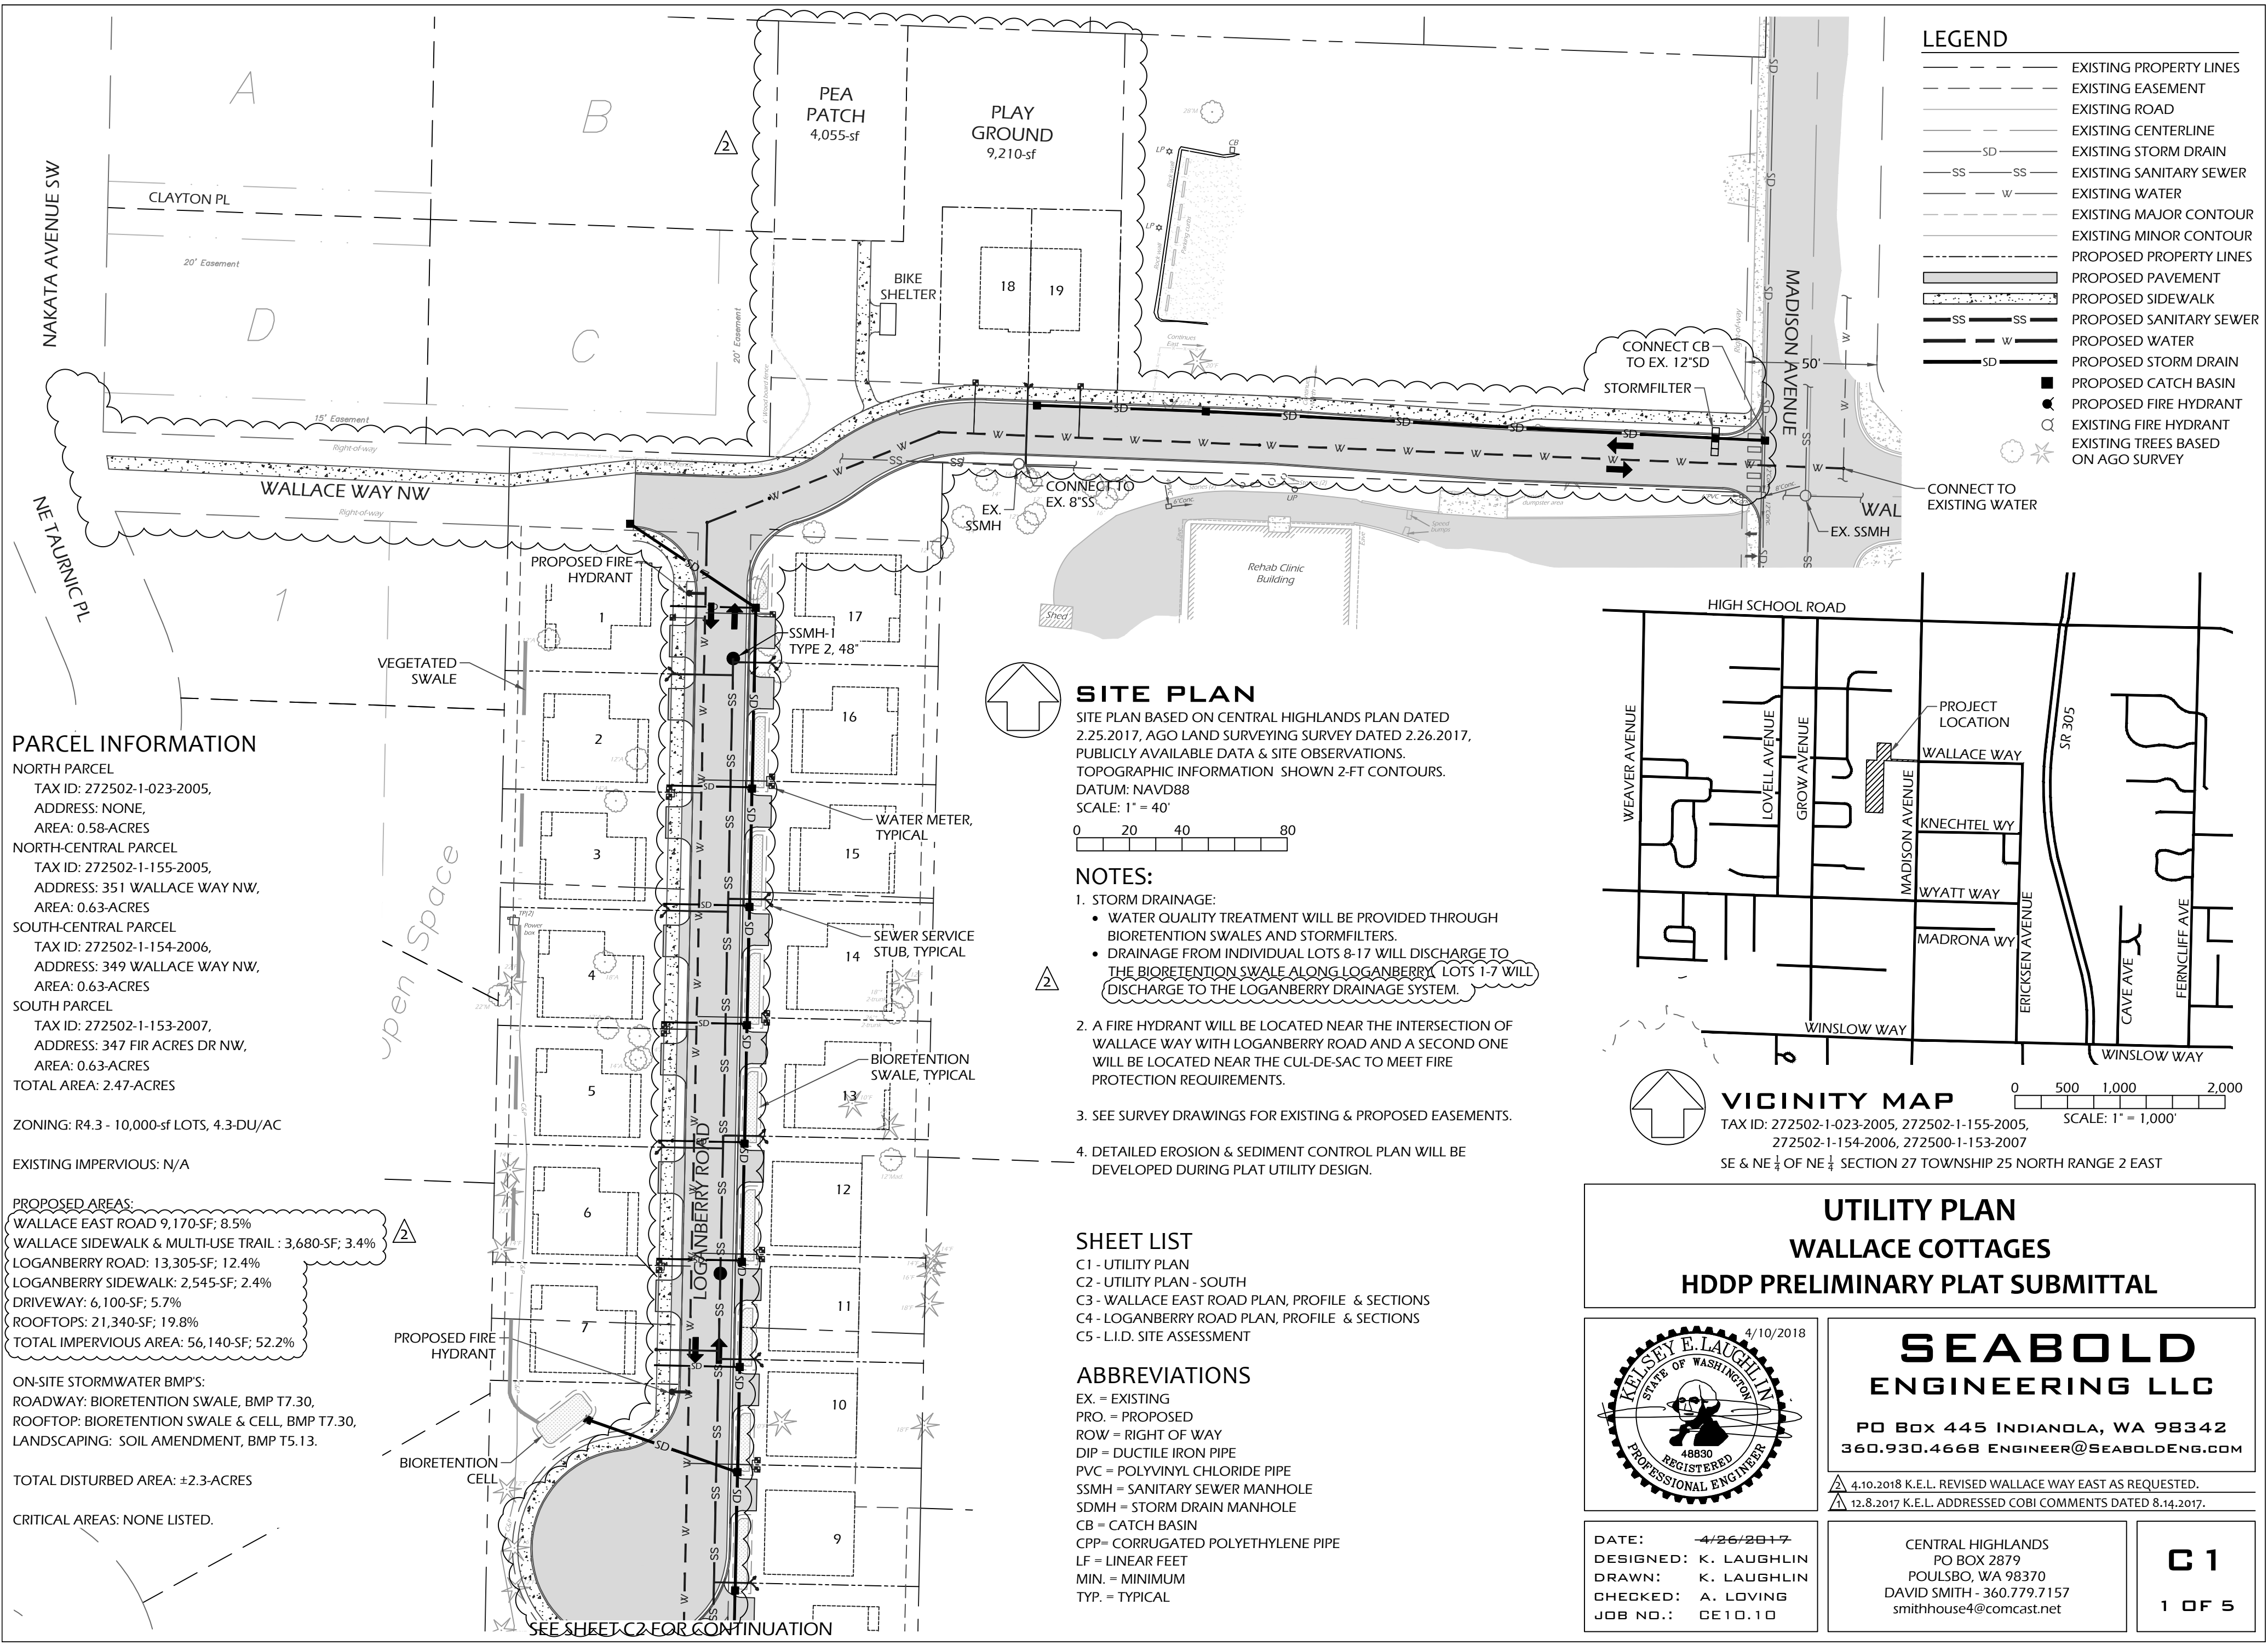


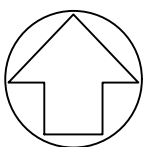

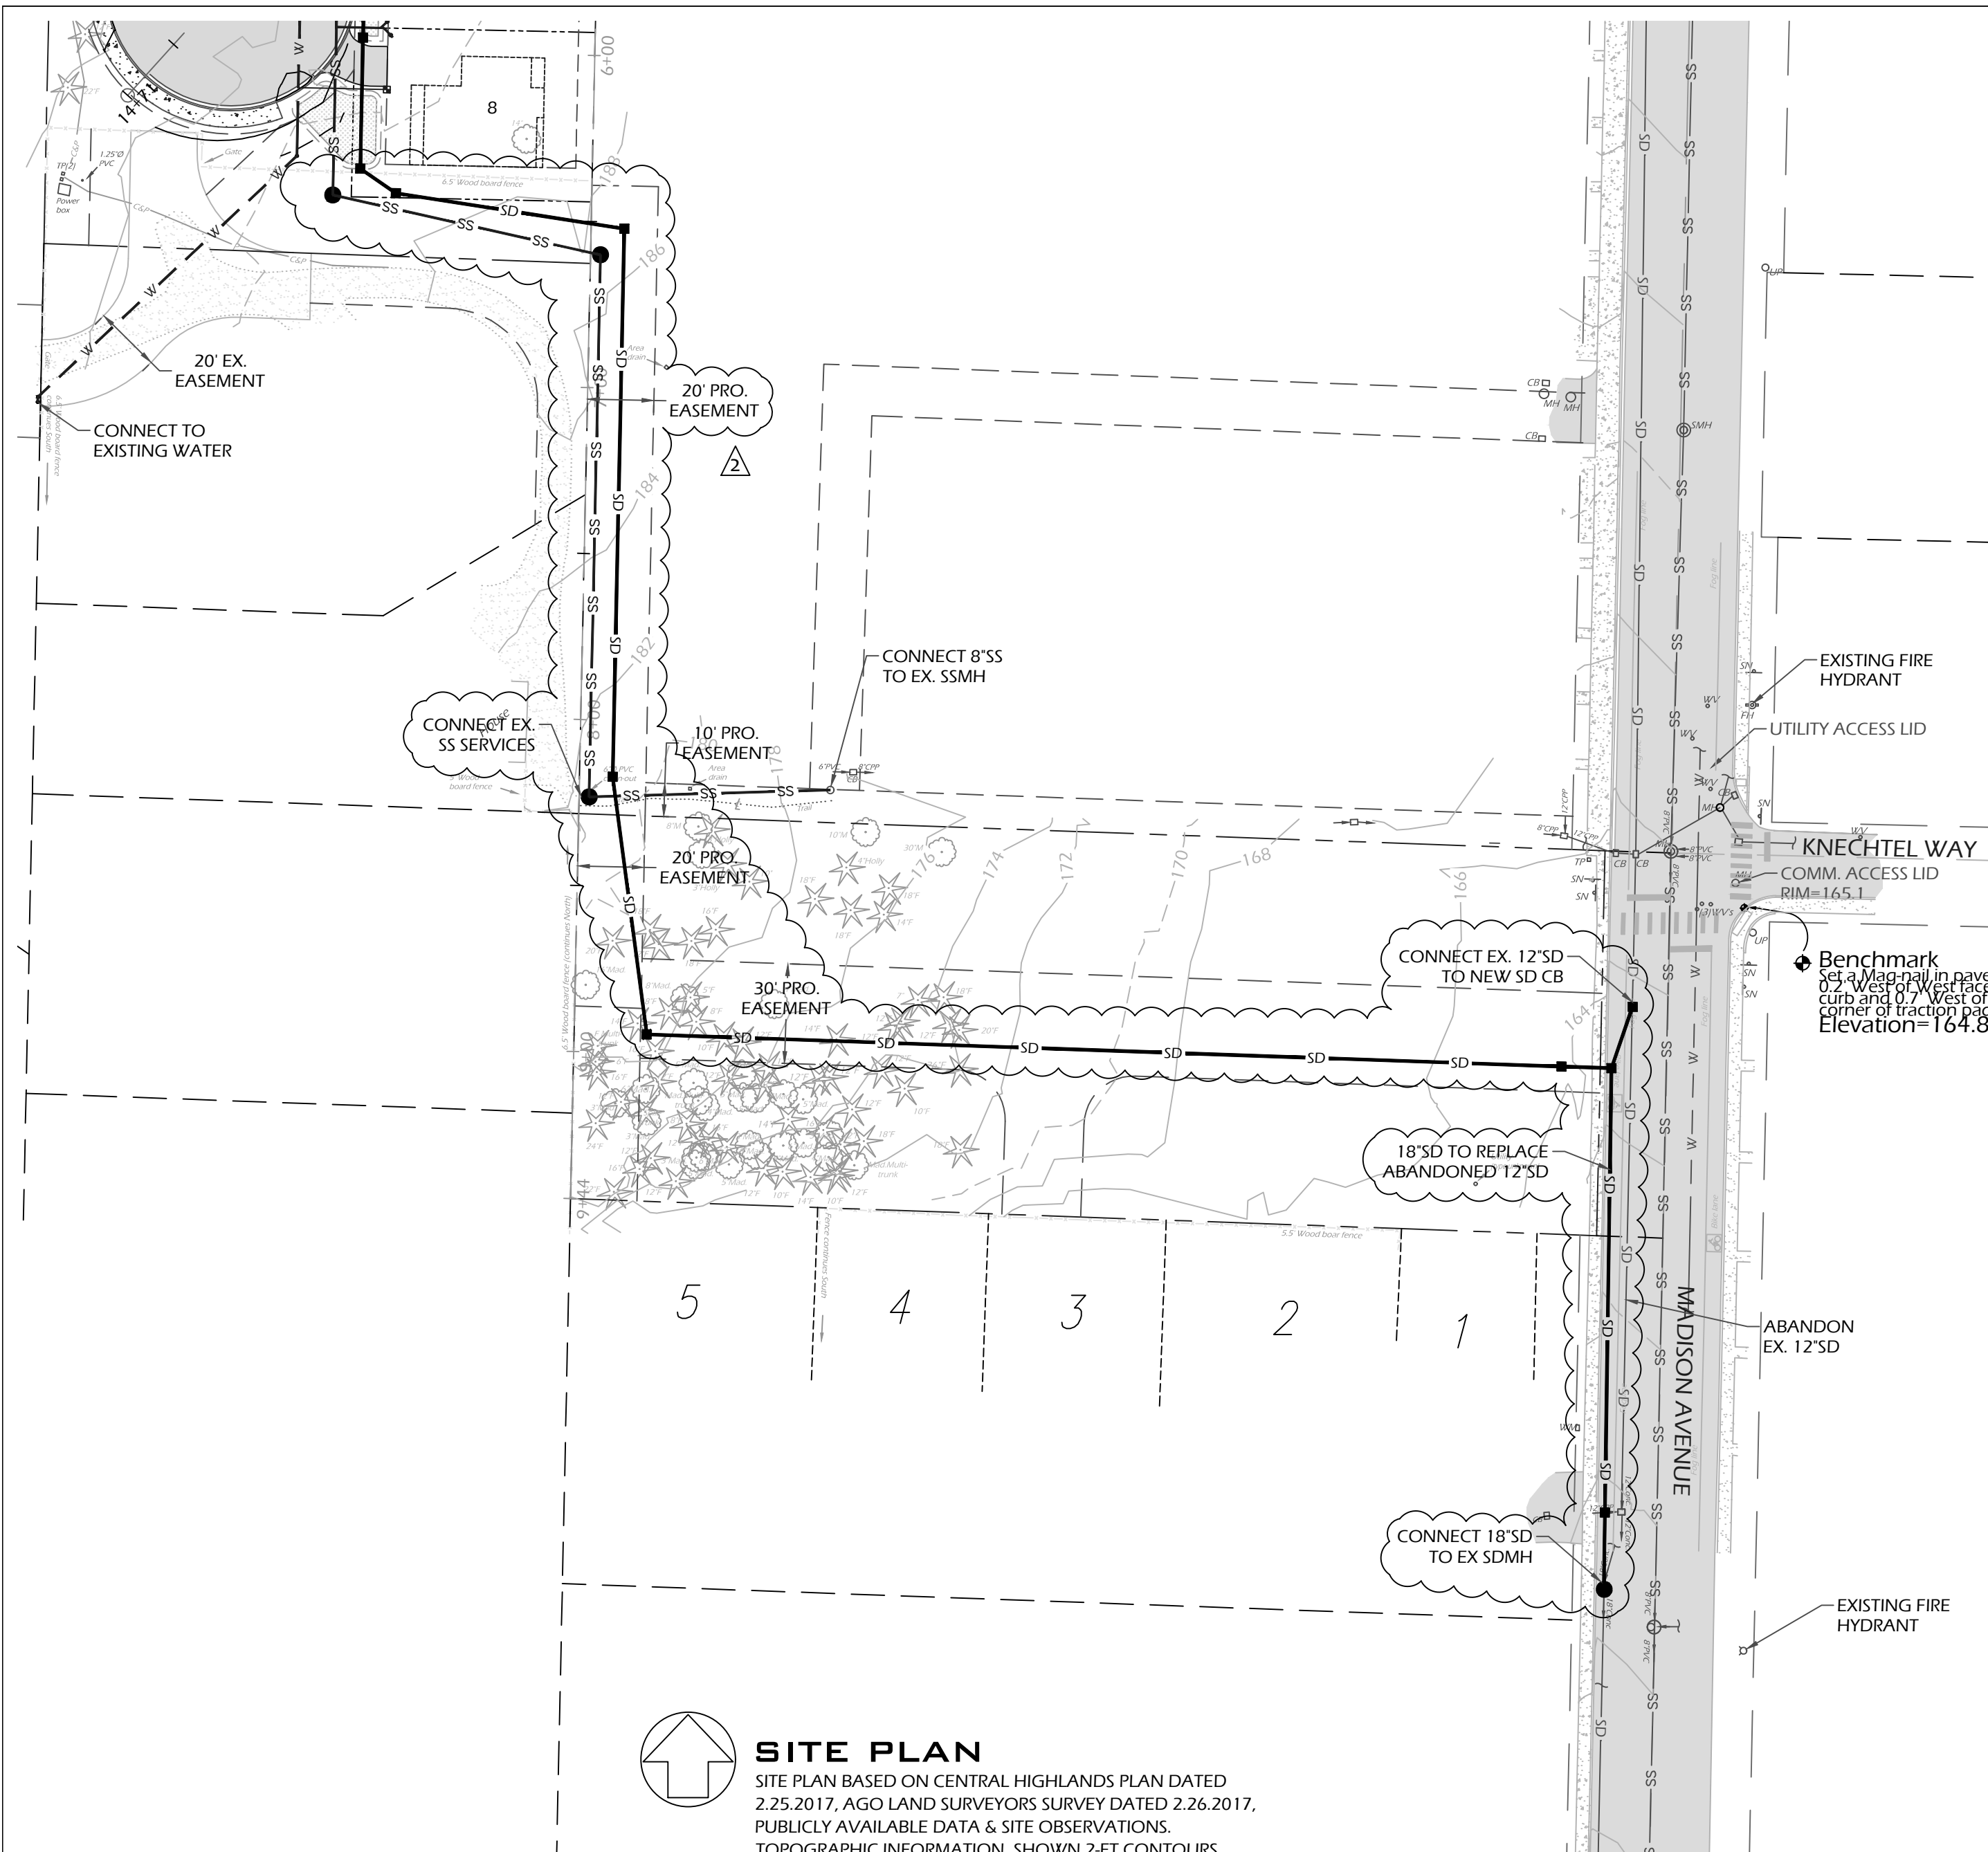


SITE PLAN

SITE PLAN BASED ON CENTRAL HIGHLANDS PLAN DATED 2.25.2017, AGO LAND SURVEYORS SURVEY DATED 2.26.2017, PUBLICLY AVAILABLE DATA & SITE OBSERVATIONS. TOPOGRAPHIC INFORMATION SHOWN 2-FT CONTOURS. DATUM: NAVD88 SCALE: 1" = 40'

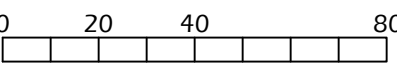

**UTILITY PLAN - SOUTH
WALLACE COTTAGES
HDDP PRELIMINARY PLAT SUBMITTAL**

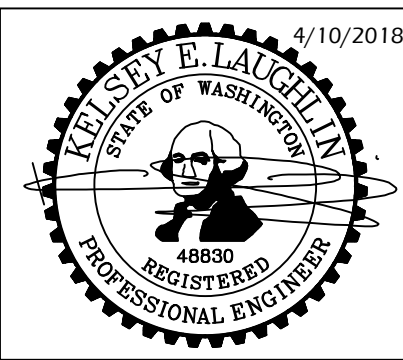


**SEABOLD
ENGINEERING LLC**

PO BOX 445 INDIANOLA, WA 98342
360.930.4668 ENGINEER@SEABOLDENG.COM

4.10.2018 K.E.L. REVISED WALLACE WAY EAST AS REQUESTED.
12.8.2017 K.E.L. ADDRESSED COBI COMMENTS DATED 8.14.2017.




DATE: ~~4/26/2017~~
DESIGNED: K. LAUGHLIN
DRAWN: K. LAUGHLIN
CHECKED: A. LOVING
JOB NO.: CE10.10

CENTRAL HIGHLANDS
PO BOX 2879
POULSBORO, WA 98370
DAVID SMITH - 360.779.7157
smithhouse4@comcast.net

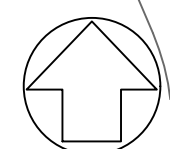



SITE PLAN

SITE PLAN BASED ON CENTRAL HIGHLANDS PLAN DATED 2.25.2017, AGO LAND SURVEYORS SURVEY DATED 2.26.2017, PUBLICLY AVAILABLE DATA & SITE OBSERVATIONS.
TOPOGRAPHIC INFORMATION SHOWN 2-FT CONTOURS.
DATUM: NAVD88
SCALE: 1" = 40'

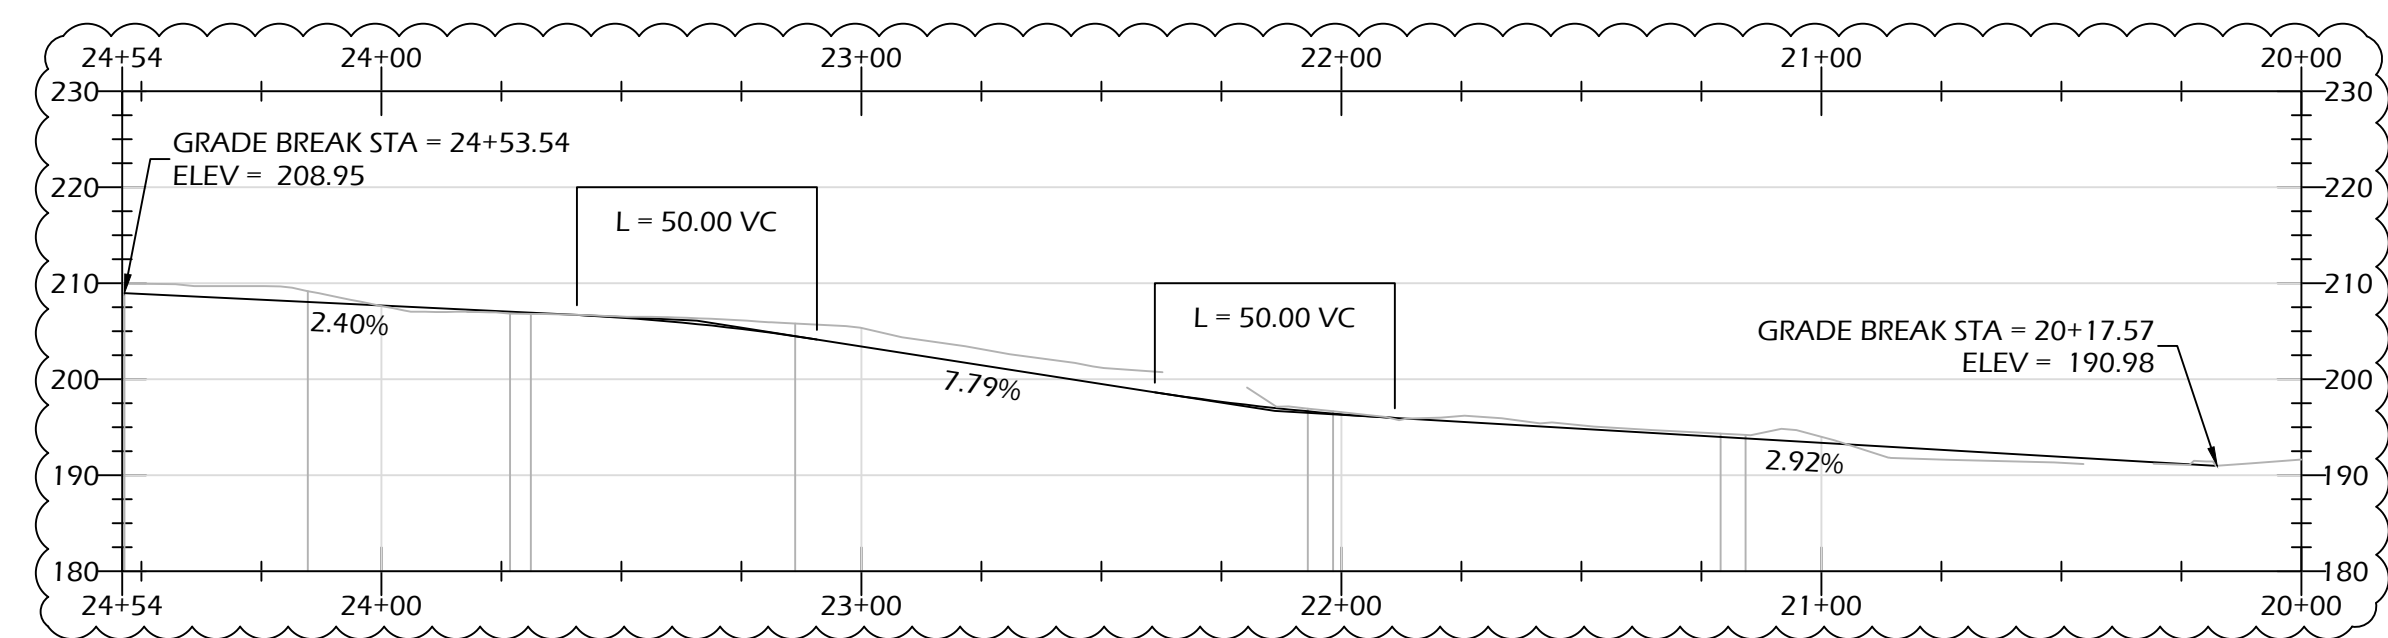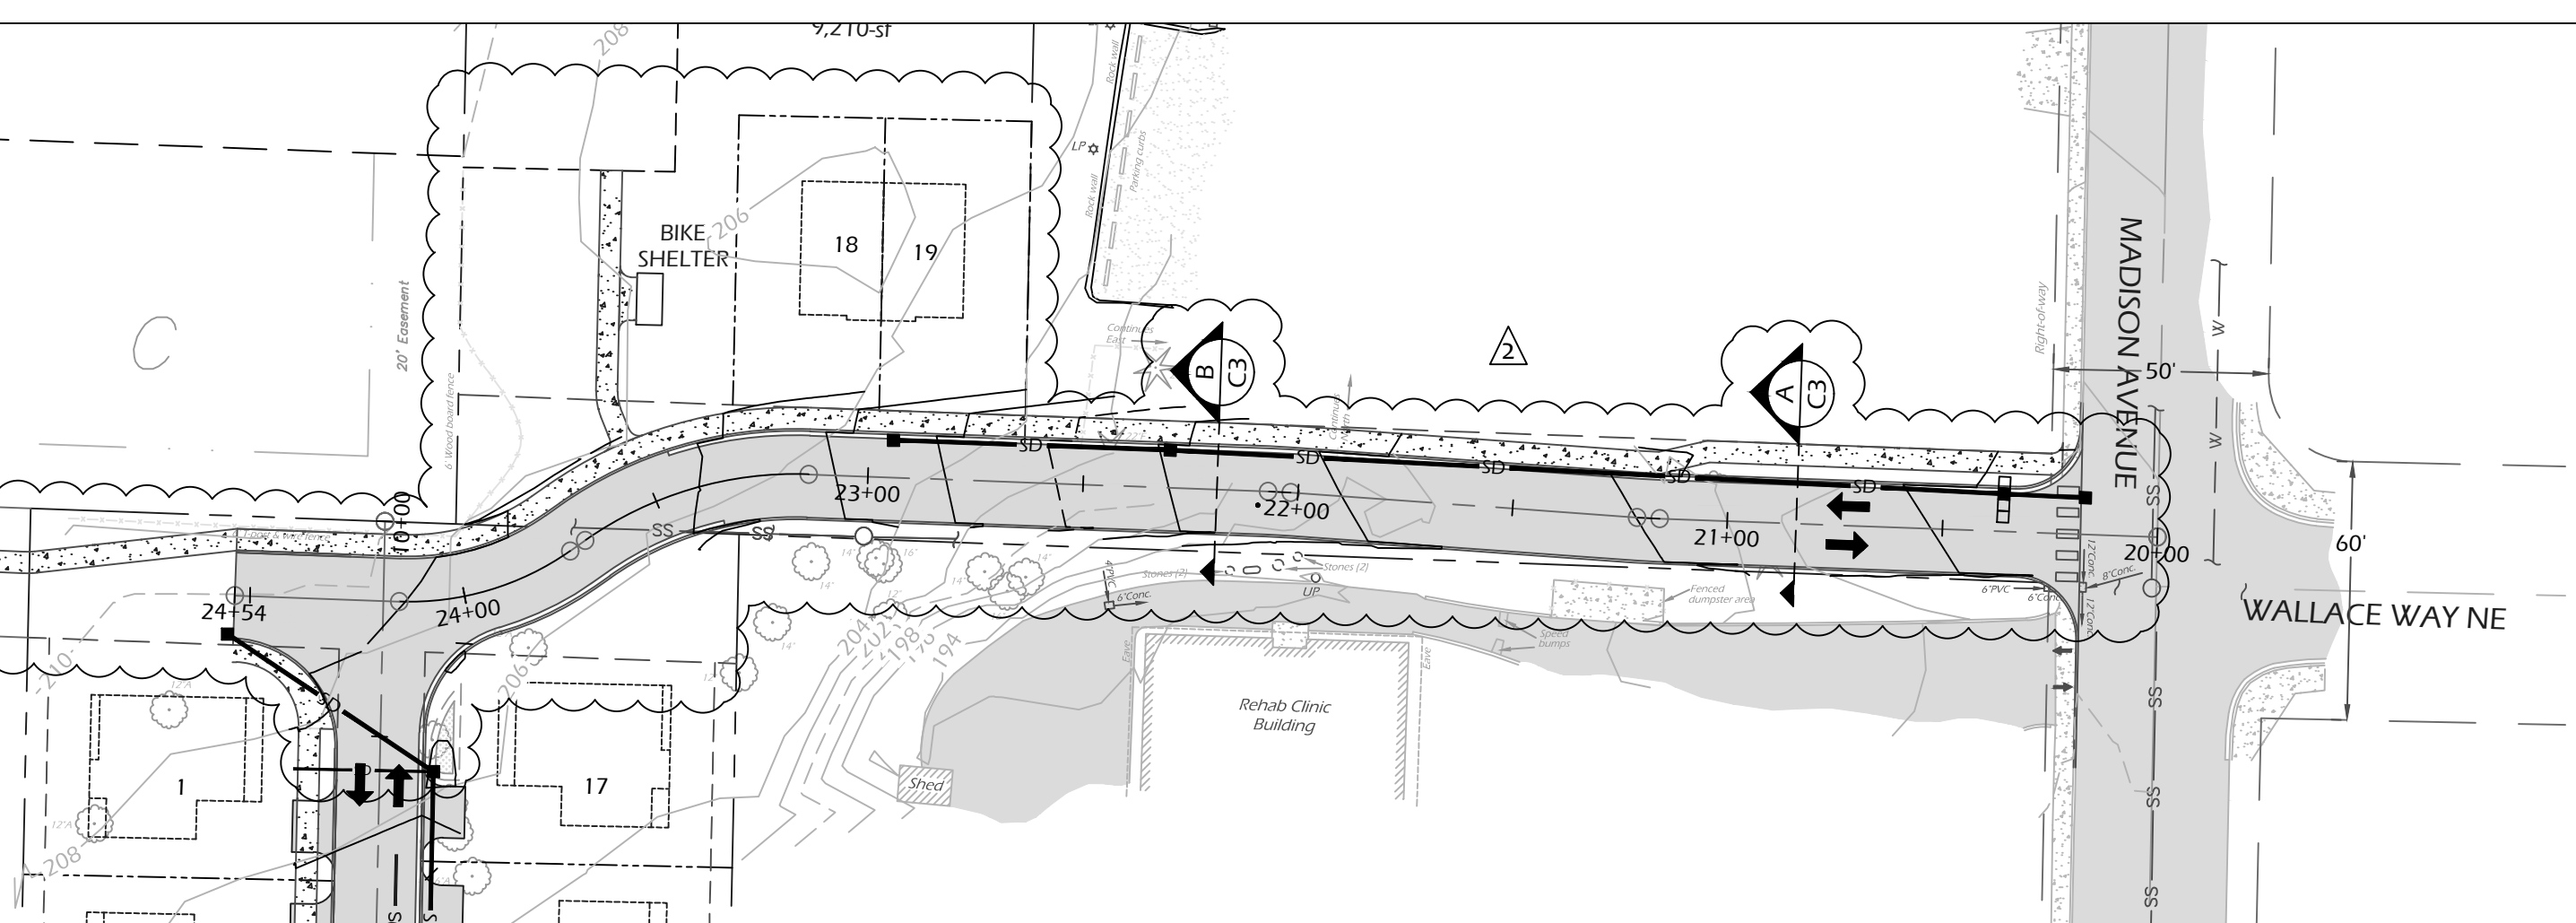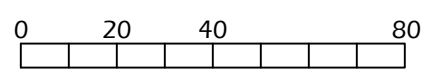



ROAD PROFILE STA 20+00 - 24+54

SCALE: 1" = 40' H
1" = 20' V
ELEVATIONS SHOWN AT ROAD CENTERLINE

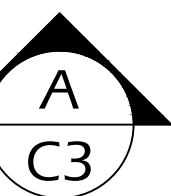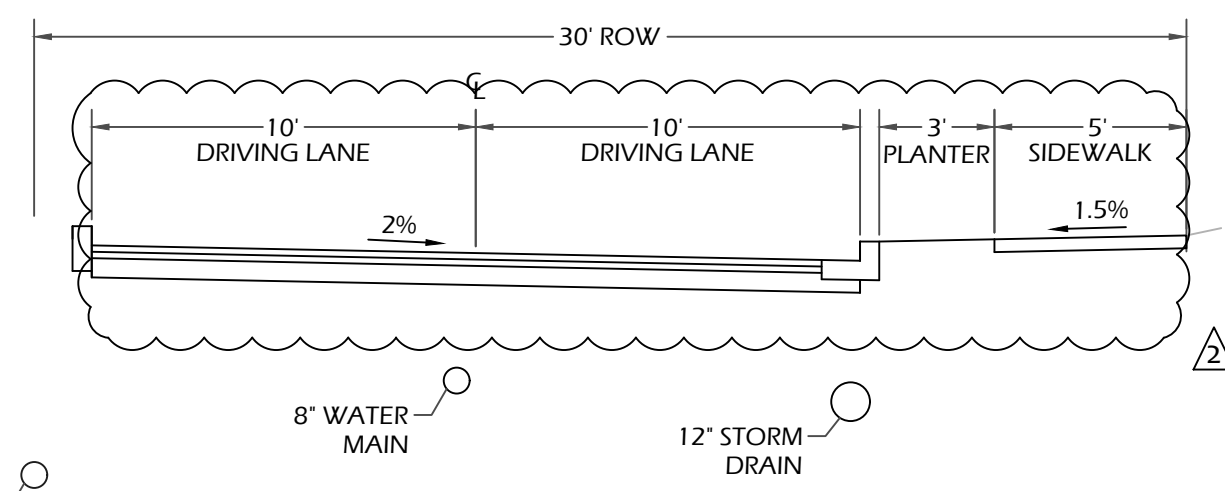

ROAD SECTION

SCALE: 1" = 5'

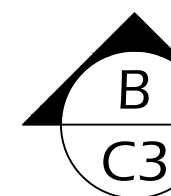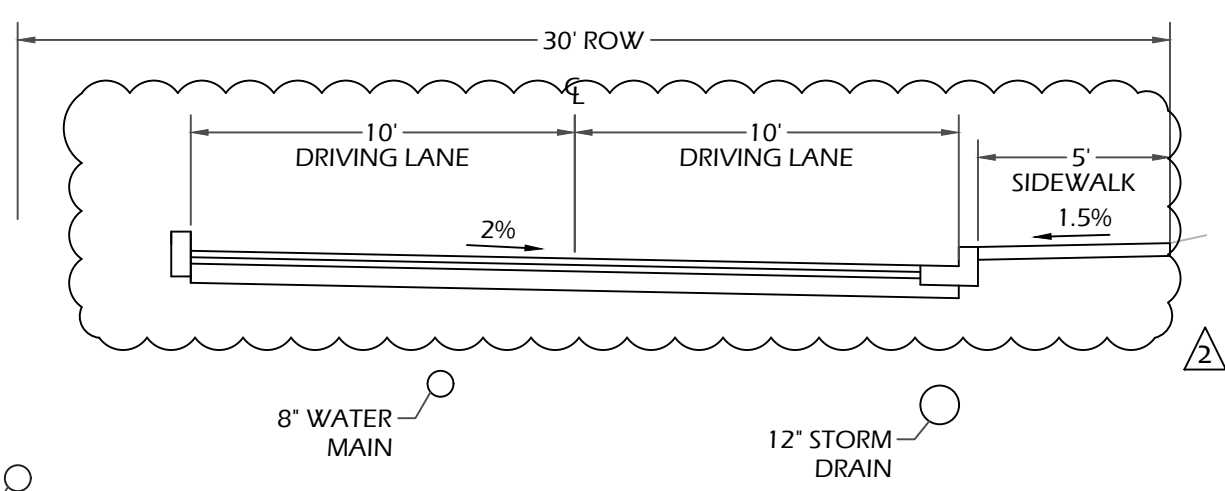

ROAD SECTION

SCALE: 1" = 5'

WALLACE EAST PLAN, PROFILE & SECTIONS WALLACE COTTAGES HDDP PRELIMINARY PLAT SUBMITTAL




DATE: ~~4/26/2017~~
DESIGNED: K. LAUGHLIN
DRAWN: K. LAUGHLIN
CHECKED: A. LOVING
JOB NO.: CE10.10

**SEABOLD
ENGINEERING LLC**
PO BOX 445 INDIANOLA, WA 98342
360.930.4668 ENGINEER@SEABOLDENG.COM

4.10.2018 K.E.L. REVISED WALLACE WAY EAST AS REQUESTED.
12.8.2017 K.E.L. ADDRESSED COBI COMMENTS DATED 8.14.2017.

CENTRAL HIGHLANDS
PO BOX 2879
POULSBORO, WA 98370
DAVID SMITH - 360.779.7157
smithhouse4@comcast.net


C3
3 OF 5

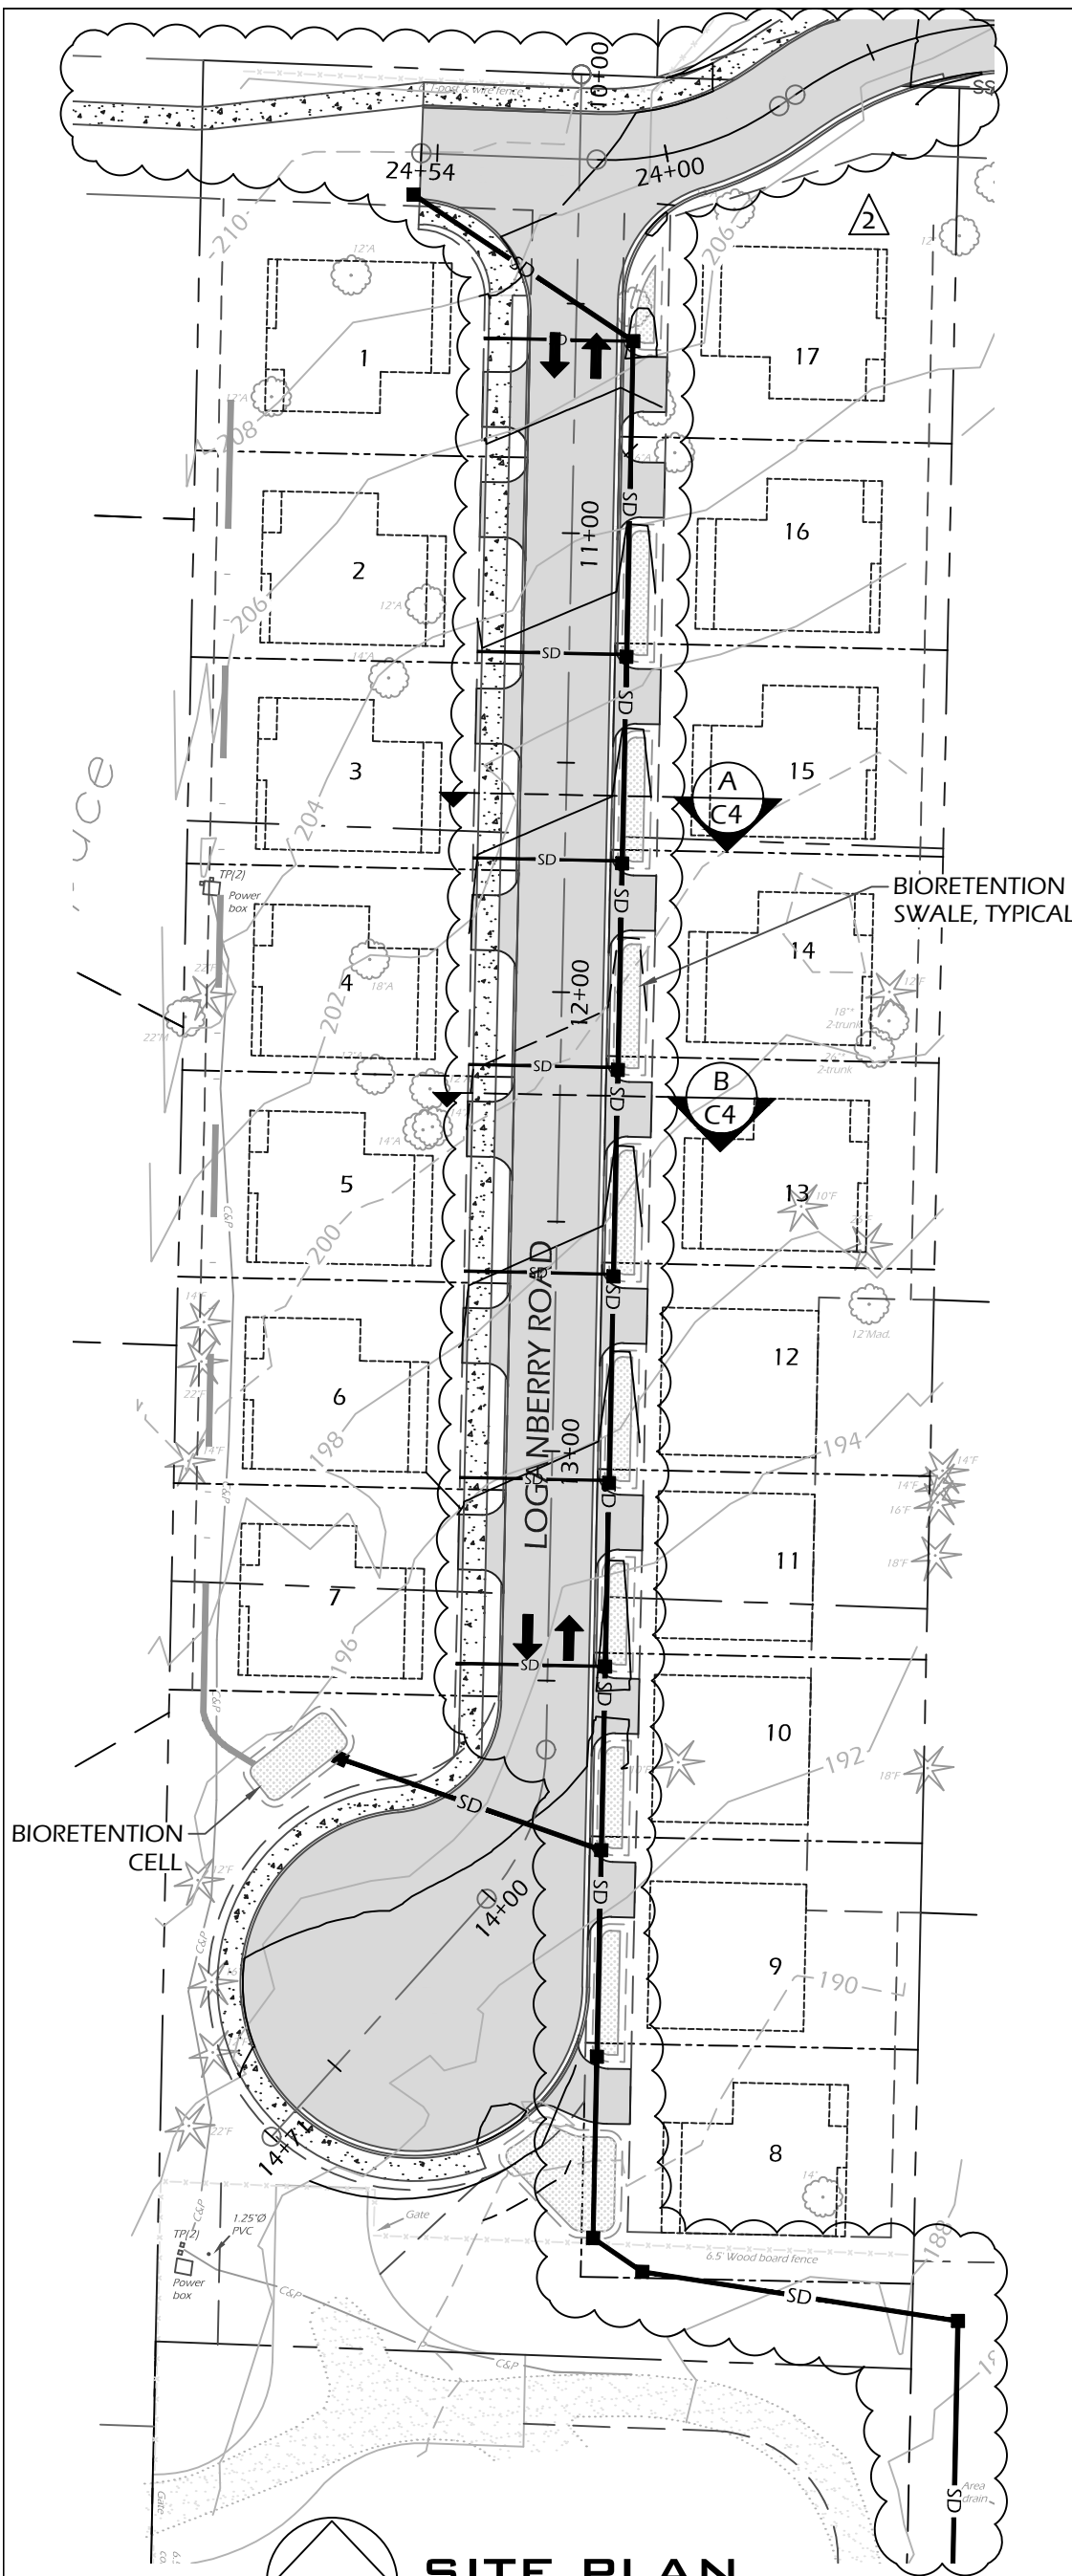


SITE PLAN

SITE PLAN BASED ON CENTRAL HIGHLANDS PLAN DATED 2.25.2017, AGO LAND SURVEYING SURVEY DATED 2.26.2017, PUBLICLY AVAILABLE DATA & SITE OBSERVATIONS. TOPOGRAPHIC INFORMATION SHOWN 2-FT CONTOURS. DATUM: NAVD88 SCALE: 1" = 40'


0 20 40 80

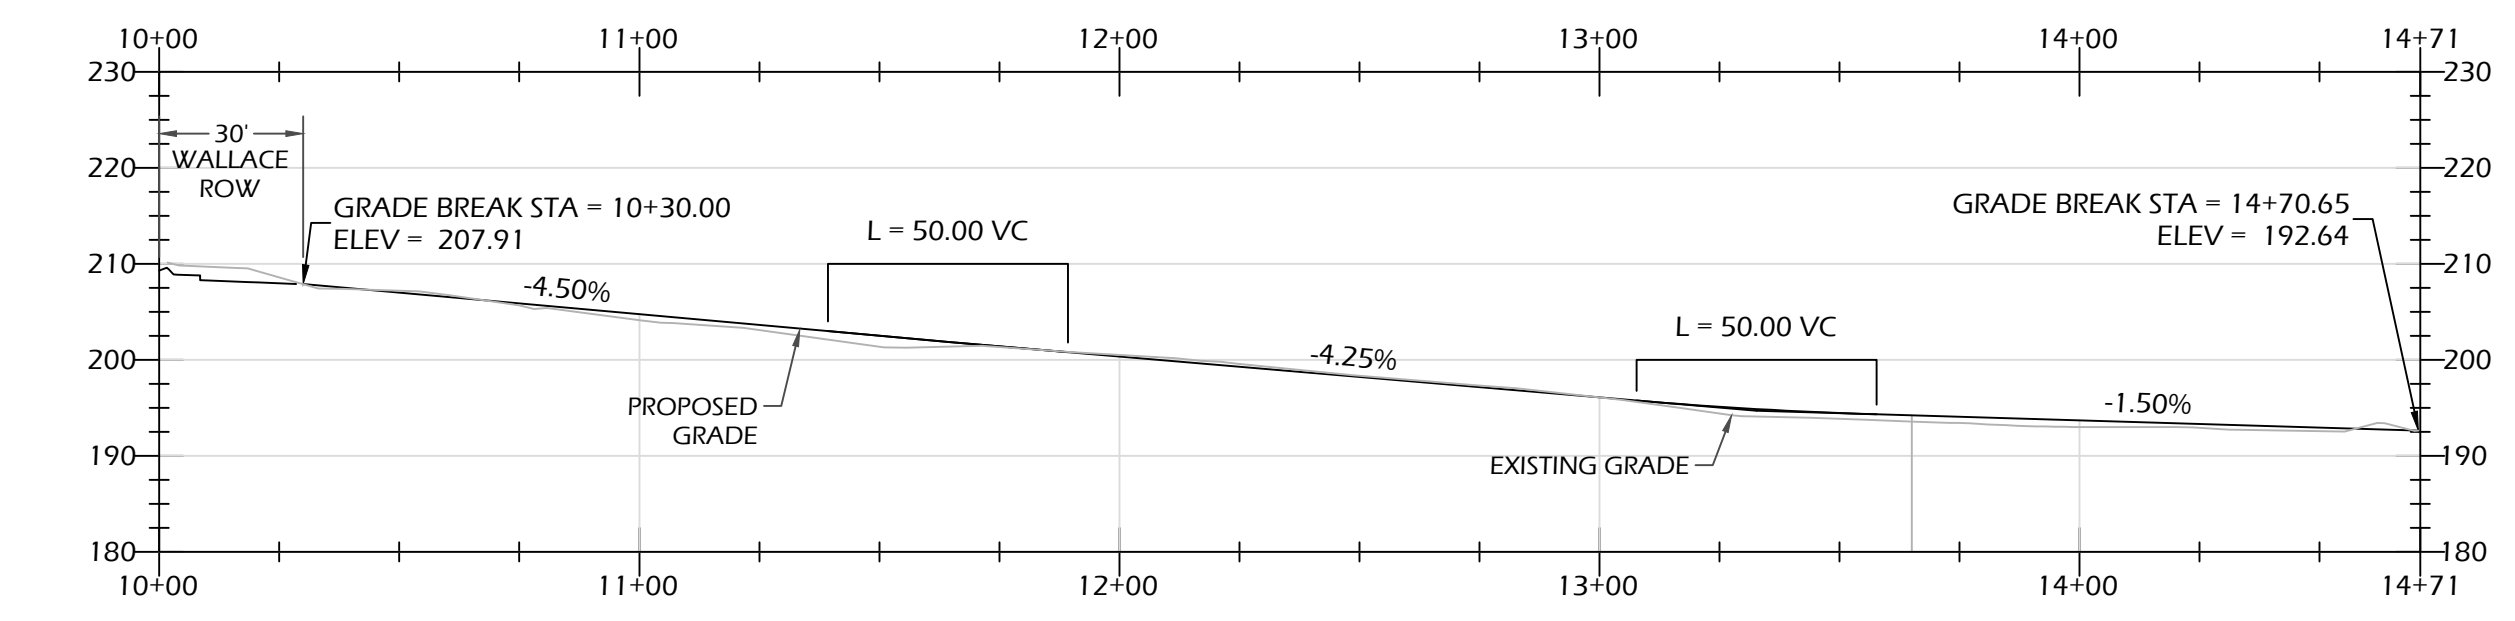

ROAD PROFILE STA 10+00 - 14+71
SCALE: 1" = 40' H
1" = 20' V

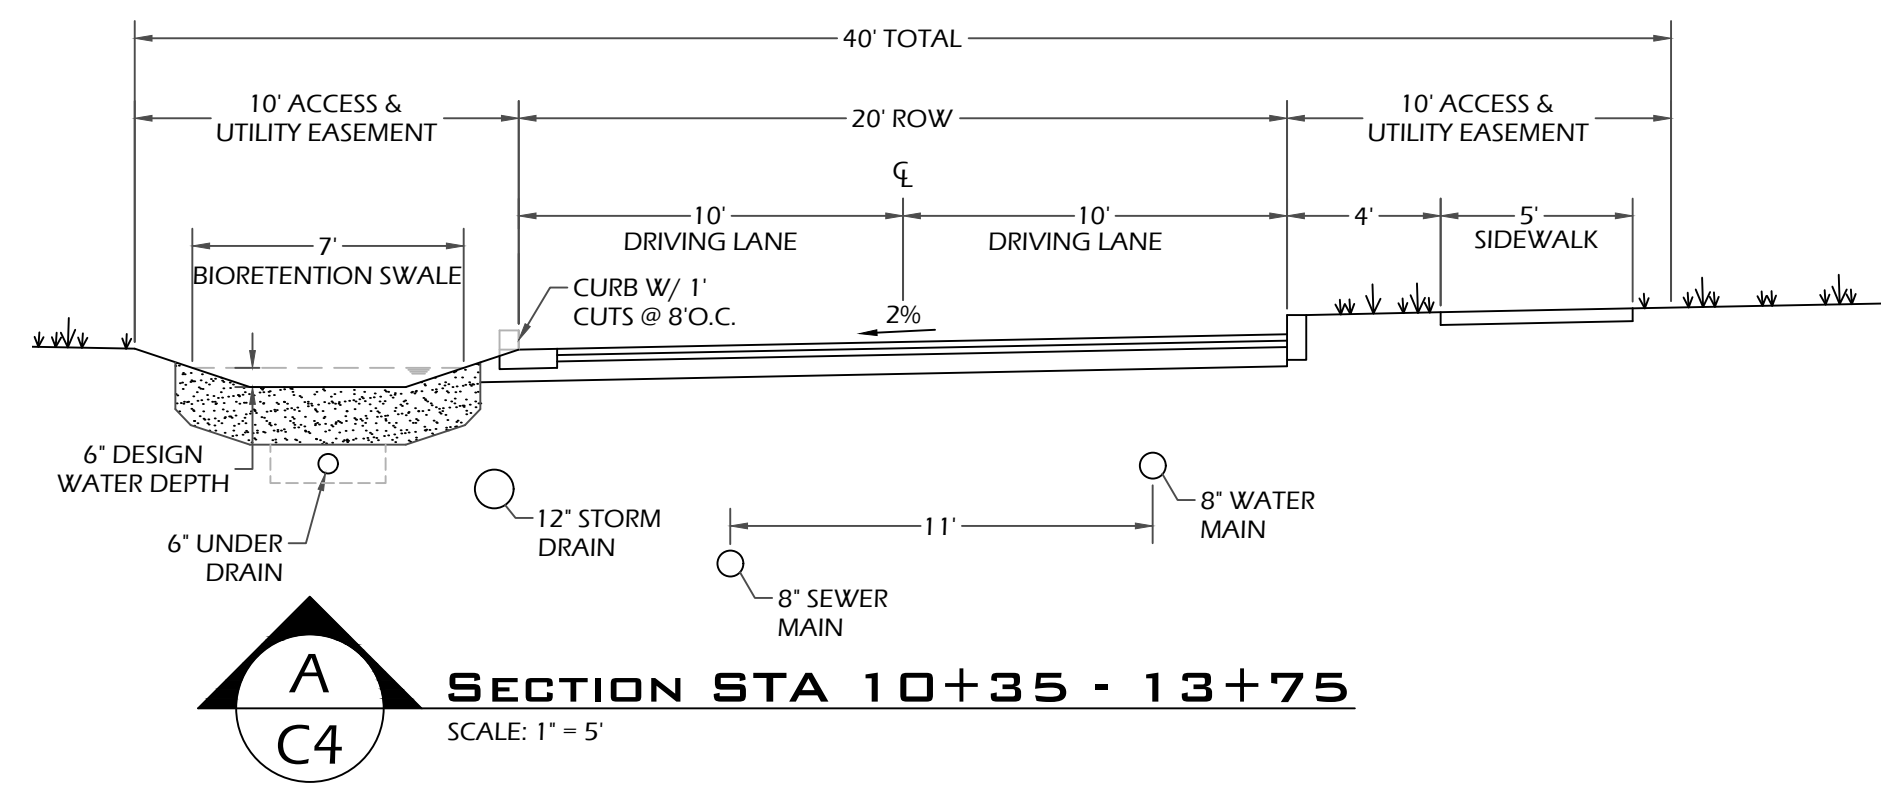


SECTION STA 10+35 - 13+75
SCALE: 1" = 5'

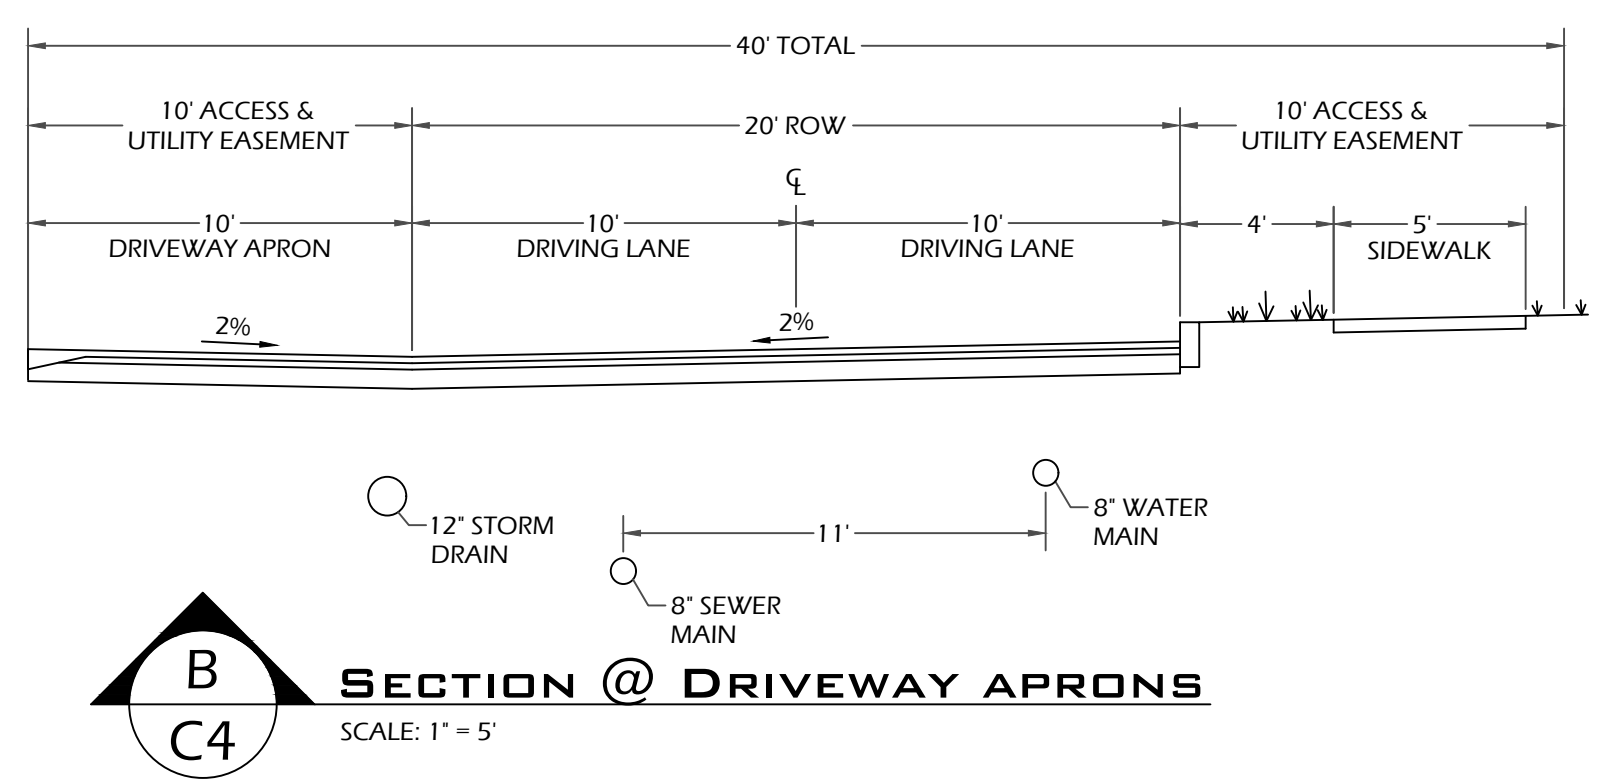

SECTION @ DRIVEWAY APRONS
SCALE: 1" = 5'

LOGANBERRY RD PLAN, PROFILE & SECTIONS
WALLACE COTTAGES
HDDP PRELIMINARY PLAT SUBMITTAL

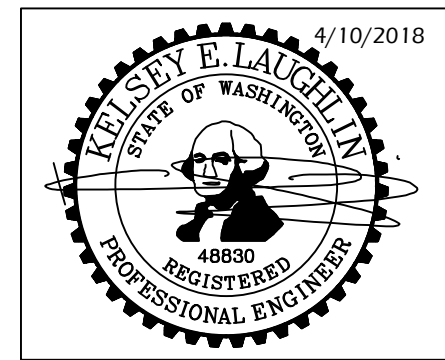



DATE: ~~4/26/2017~~
DESIGNED: K. LAUGHLIN
DRAWN: K. LAUGHLIN
CHECKED: A. LOVING
JOB NO.: CE10.10

SEABOLD ENGINEERING LLC

PO BOX 445 INDIANOLA, WA 98342
360.930.4668 ENGINEER@SEABOLDENG.COM


4.10.2018 K.E.L. REVISED WALLACE WAY EAST AS REQUESTED.
12.8.2017 K.E.L. ADDRESSED COBI COMMENTS DATED 8.14.2017.

CENTRAL HIGHLANDS
PO BOX 2879
POULSBORO, WA 98370
DAVID SMITH - 360.779.7157
smithhouse4@comcast.net

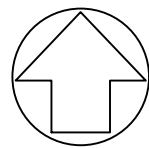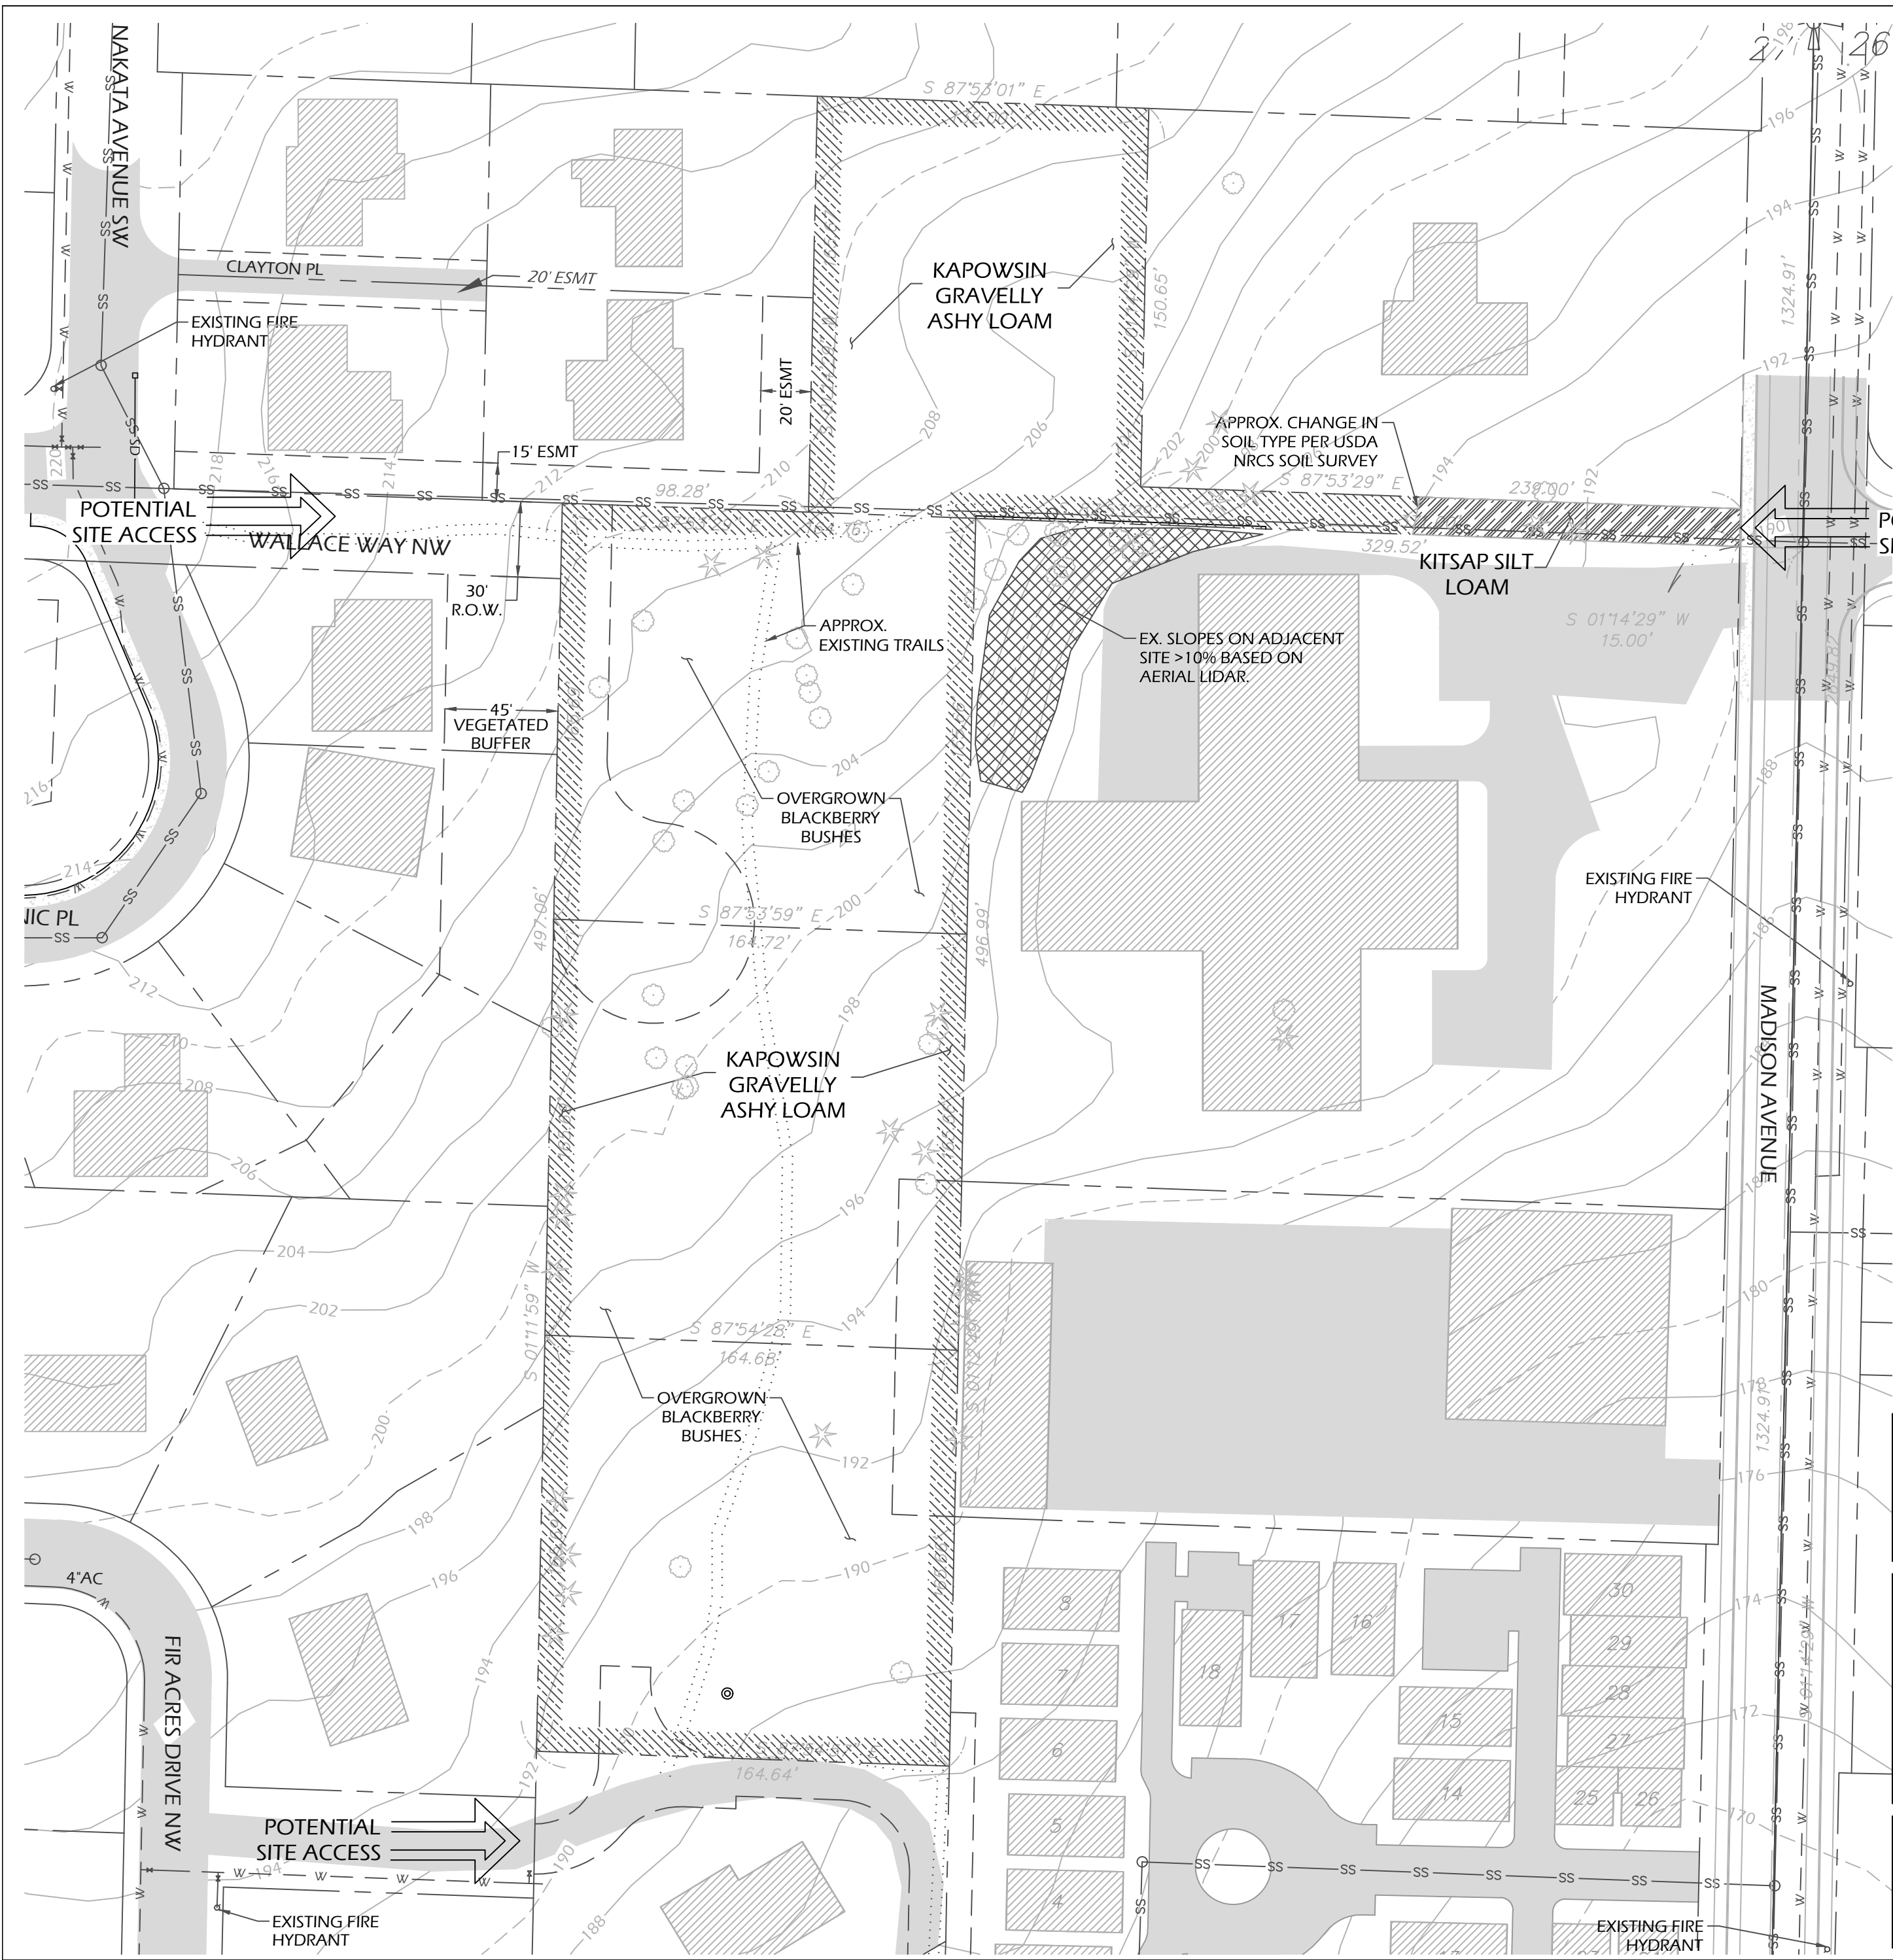

SITE PLAN


SITE PLAN BASED ON PUBLICLY AVAILABLE DATA & SITE OBSERVATIONS. TOPOGRAPHIC INFORMATION BASED ON KITSAP COUNTY PUD AERIAL LIDAR 2-FT CONTOURS, NOT A SURVEY.
DATUM: NAVD88
SCALE: 1" = 50'

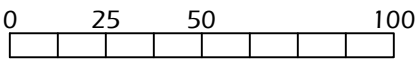

LEGEND

- EXISTING PROPERTY LINES
- EXISTING ROAD
- EXISTING CENTERLINE
- SD --- EXISTING STORM DRAIN
- SS --- SS --- EXISTING SANITARY SEWER
- W --- EXISTING WATER MAIN
- EXISTING MAJOR CONTOUR
- EXISTING MINOR CONTOUR
- [Hatched Box] EXISTING BUILDINGS
- [Solid Grey Box] EXISTING PAVEMENT
- [Star Symbol] EXISTING TREES BASED ON AGO SURVEY

**L.I.D. SITE ASSESSMENT PLAN
WALLACE COTTAGES
HDDP PRELIMINARY PLAT SUBMITTAL**

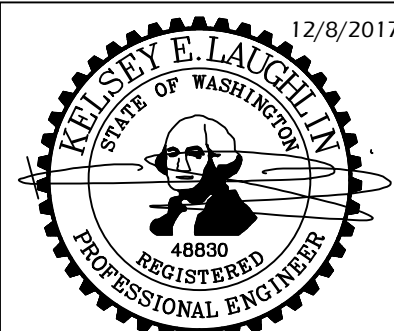

DATE: 4/26/2017
DESIGNED: K. LAUGHLIN
DRAWN: K. LAUGHLIN
CHECKED: A. LOVING
JOB NO.: CE10.10

**SEABOLD
ENGINEERING LLC**
PO BOX 445 INDIANOLA, WA 98342
360.930.4668 ENGINEER@SEABOLDENG.COM

12.8.2017 K.E.L. ADDRESSED COBI COMMENTS DATED 8.14.2017.

CENTRAL HIGHLANDS
PO BOX 2879
POULSBORO, WA 98370
DAVID SMITH - 360.779.7157
smithhouse4@comcast.net

C5
5 OF 5