

PARCEL NO. 4189-000-008-0103

NEIGHBORS
EXISTING ROCK BULKHEAD

NEW BULKHEAD
NET 10'

DRAIN PIPE WITH
ROCK BULKHEAD
PAVER RETAINMENT
CONCRETE
CONCRETE

MOVE TO
BACK 1' IN
GAIN

EXISTING
OFFSETS

NEIGHBORS
ROCK BULKHEAD

TAPE
DISTANCE

5° 47' 38" E

STONE STEPS

TRAIL

10750 NE BRIDGEMERE ROAD
PARCEL NO. 4189-000-007-0531

PATIO

TOP OF SLOPE


ROCKERY

STONE STEPS

NE E

MANLOWE
AS BUILT OFFSET


NTS

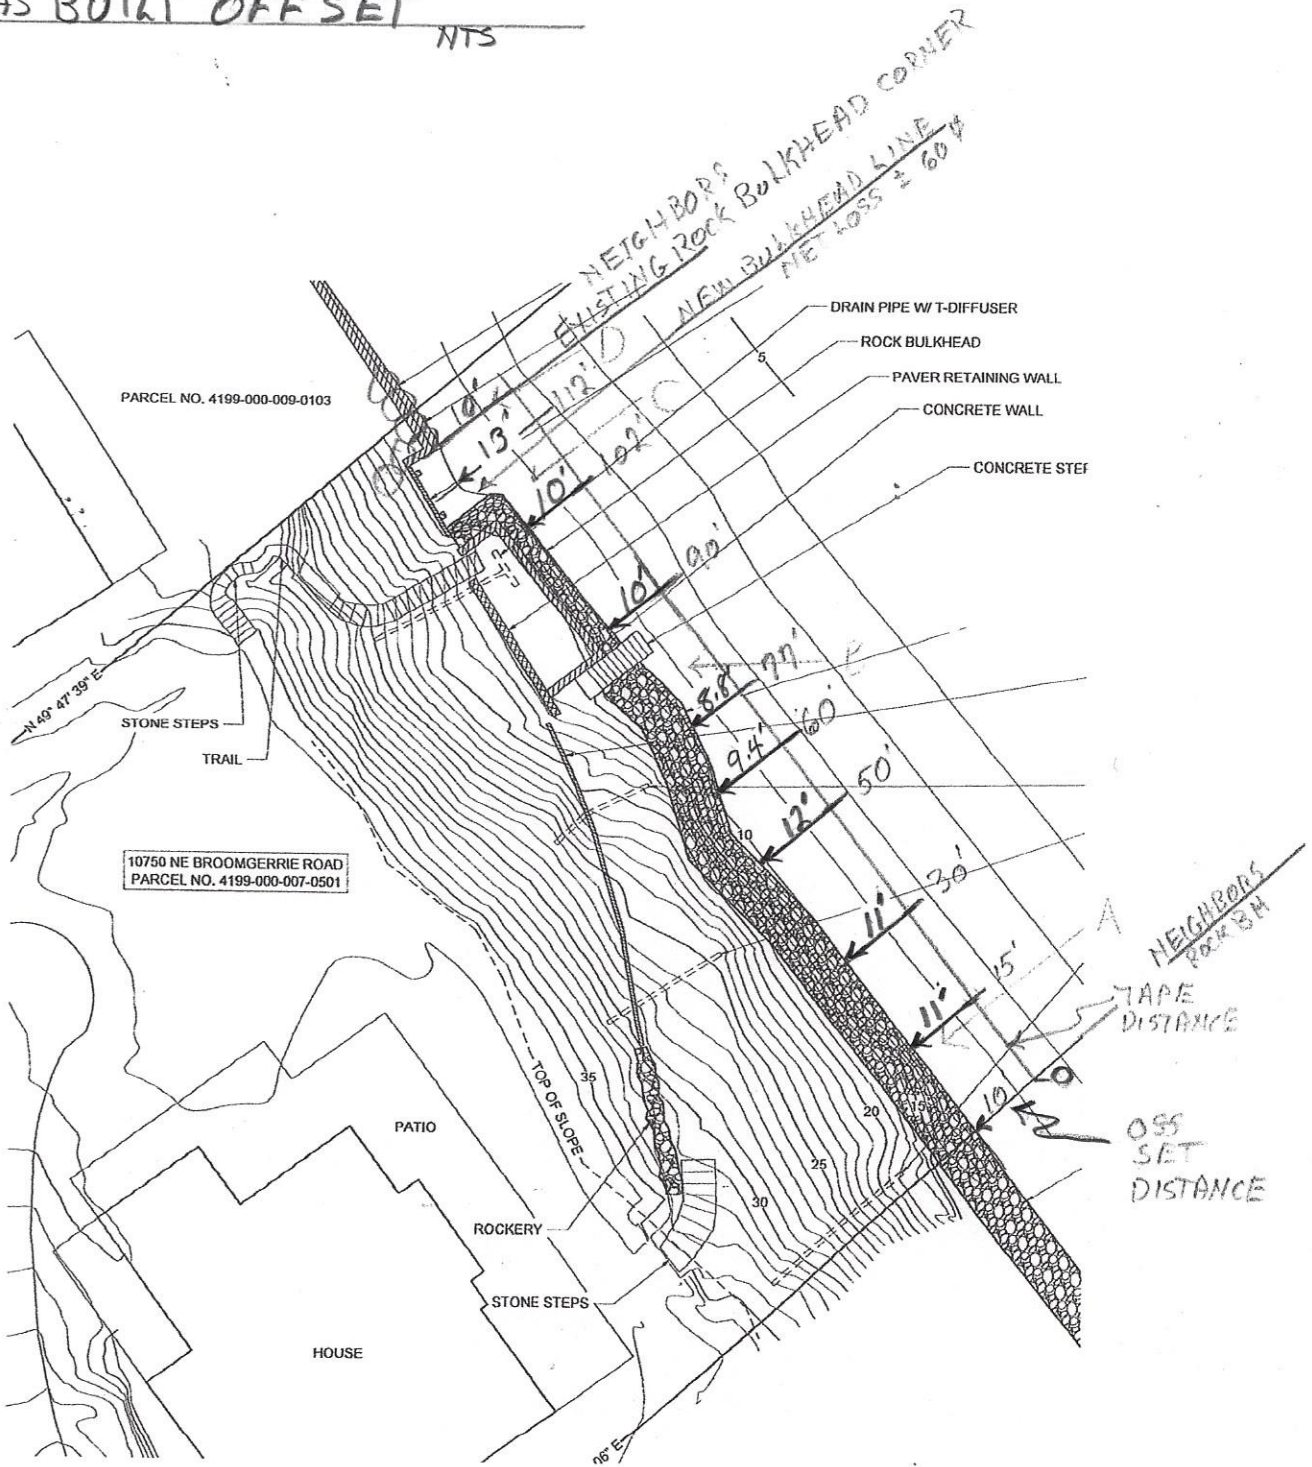

PARTIAL SITE PLAN

NOT TO SCALE



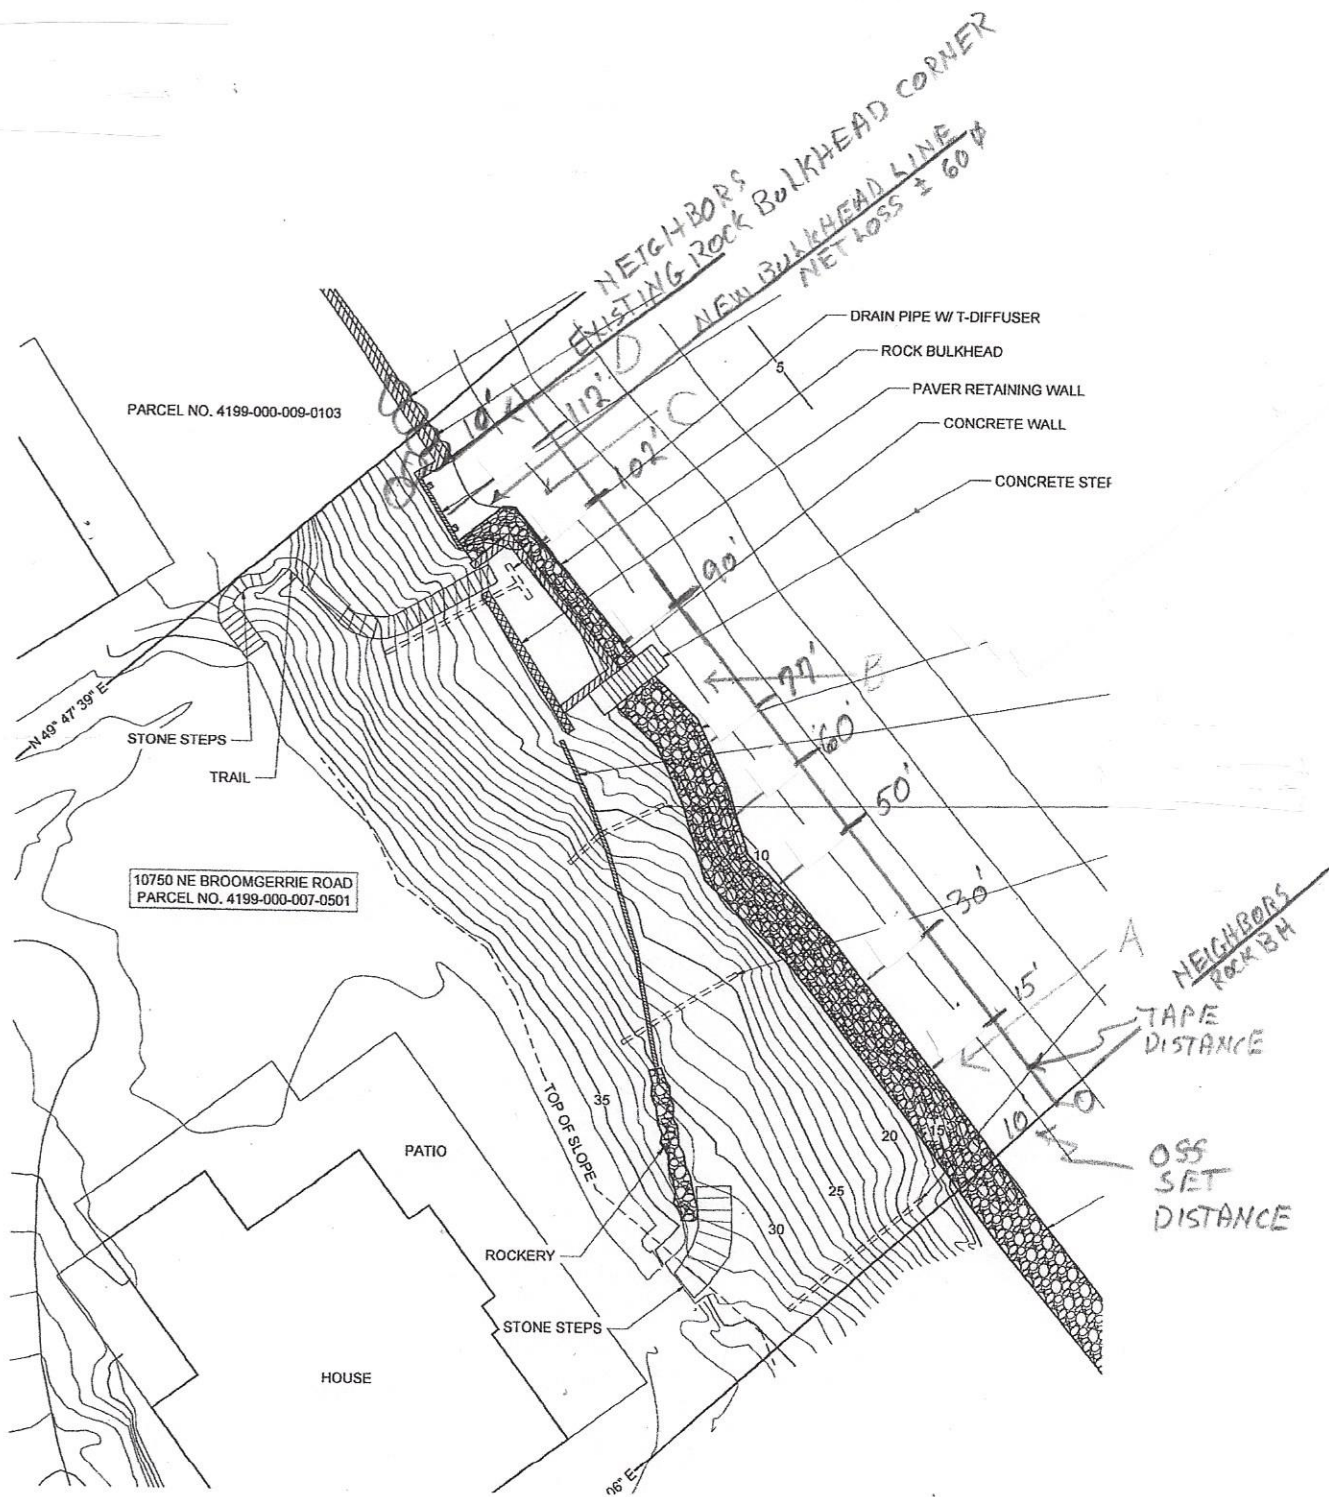

PARTIAL SITE PLAN

NOT TO SCALE

